

849 - 2 Street SE Medicine Hat, AB

SHEET LIST					
Page#	Sheet Number	Sheet Name	Current Revision or Issue	Description	Revision Date
ARCHITECTURAL					
1	A0.00	COVER & NOTES	2	DP SUB#2: UTILITY SIZES & CURB BOUNDARIES	2025-02-19
2	A1.00	SITE PLAN - EXISTING	2	DP SUB#2: UTILITY SIZES & CURB BOUNDARIES	2025-02-19
3	A1.01	SITE PLAN - NEW	2	DP SUB#2: UTILITY SIZES & CURB BOUNDARIES	2025-02-19
4	A1.02	SITE PLAN - EXISTING STORMWATER & GRADING	2	DP SUB#2: UTILITY SIZES & CURB BOUNDARIES	2025-02-19
5	A1.03	SITE PLAN - STORMWATER & GRADING	2	DP SUB#2: UTILITY SIZES & CURB BOUNDARIES	2025-02-19
6	A1.04	SITE PLAN - UTILITIES	2	DP SUB#2: UTILITY SIZES & CURB BOUNDARIES	2025-02-19
7	A1.05	SITE PLAN - LANDSCAPING	2	DP SUB#2: UTILITY SIZES & CURB BOUNDARIES	2025-02-19
8	A1.11	FLR. PLAN - BASEMENT - BLDG. A	2	DP SUB#2: UTILITY SIZES & CURB BOUNDARIES	2025-02-19
9	A1.12	FLR. PLAN - MAIN LEVEL - BLDG. A	2	DP SUB#2: UTILITY SIZES & CURB BOUNDARIES	2025-02-19
10	A1.13	FLR. PLAN - 2ND-4TH LEVEL - BLDG. A	2	DP SUB#2: UTILITY SIZES & CURB BOUNDARIES	2025-02-19
11	A1.15	FLR. PLAN - ROOF LEVEL - BLDG. A	2	DP SUB#2: UTILITY SIZES & CURB BOUNDARIES	2025-02-19
12	A2.00	ELEVATION VIEW - BLDG. A	2	DP SUB#2: UTILITY SIZES & CURB BOUNDARIES	2025-02-19
13	A2.01	ELEVATION VIEW - BLDG. A	2	DP SUB#2: UTILITY SIZES & CURB BOUNDARIES	2025-02-19
14	A9.00	3D VIEW	2	DP SUB#2: UTILITY SIZES & CURB BOUNDARIES	2025-02-19



① {3D}

MEASUREMENTS AND DIMENSIONS:

- BEFORE ORDERING MATERIALS OR COMMENCING WORK THE CONTACTOR SHALL VERIFY ALL DIMENSIONS AND ELEVATIONS.
- ANY DISCREPANCIES BETWEEN DRAWINGS AND/OR SPECIFICATIONS AND EXISTING CONDITIONS SHALL BE REFERRED TO THE DESIGNER FOR ADJUSTMENT BEFORE ANY WORK AFFECTED THEREBY IS BEGUN.

All drawings, design and related documents are the property of: P.H. McNally Associates Ltd., are protected by copyright, and must be returned on request. Reproduction of drawings and documents in part or in whole is forbidden without the Engineer's permission. Drawings and documents are to be used only for the purpose for which they are issued and are not to be used for construction unless signed by the Engineer.

Drawings are not to be used for construction until reviewed and approved by the Authority Having Jurisdiction. This Authority, based on applicable codes, may require revisions and/or additions and this may result in extra costs. These costs are unforeseen and therefore are the responsibility of the Owner and/or Contractor.

Drawings must not be scaled. The Contractor must cross-reference all architectural, structural, foundation, electrical and mechanical drawings and verify all dimensions, drawings and specifications and locations of existing services. Any discrepancies must be reported to the Engineer prior to proceeding with any part of the work. Changes may require revisions and/or additions and this may result in extra costs. These costs are unforeseen and therefore are the responsibility of the Owner and/or Contractor.


The Engineer assumes no responsibility for on-site worker safety for other than their own employees. The owner and/or contractor shall bear responsibility for site safety as per the Occupation Health and Safety Act.

In the event of omissions in the provided service, P.H. McNally Associates limits its liability to the lower of the cost of remediation or payment for the received service.

All physical documents issued are property of the Owner. All intellectual property represented by these documents, as well as material documents, design documents, and digital models remain the property of the Engineer and are used with the Engineer's permission only.

2	DP SUB#2: UTILITY SIZES & CURB BOUNDARIES	2025-02-19	IAE
1	DEVELOPMENT PERMIT PRELIMINARY PRESENTATION	2025-01-22	IAE

Rev	Description	Date	by
-----	-------------	------	----

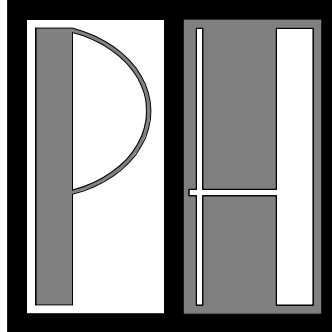

McNALLY
ASSOCIATES LTD.



PERMIT TO PRACTICE
P.H. McNally Associates Ltd.
RM SIGNATURE: _____
RM APEGA ID: 22074
DATE: 2024-11-06
PERMIT NUMBER: P# 2688
The Association of Alberta Engineers and Geoscientists of Alberta (AAG) and
DIGITAL COPY

FOR

PROJECT
2 - 38 SUITERS 5 STOREY
APARTMENT

849 - 2 Street SE Medicine Hat, AB

DRAWING TITLE
COVER & NOTES

BY: IAE CHECKED: PHM

SCALE: AS SHOWN PAGE SIZE: 36" x 24"

JOB NO: 24107-01 REV DATE: 2025-02-19

REV. 1 14
2

A0.00

FOR DEVELOPMENT PERMIT

DEVELOPMENT DESCRIPTION:

MUNICIPAL ADDRESS:	849 - 2 Street SE Medicine Hat, AB		
LEGAL DESCRIPTION:	PLAN	=	1491
	BLOCK	=	12
	LOTS	=	4 TO 20
ZONING:	ZONE 5: CENTRAL , MEDIUM DENSITY RESIDENTIAL (R-MD)		
LOT AREA:	5,131.26 m² (0.51 HA)		
BUILDING AREA:	PROPOSED BLDG. A (38)	=	8,486.33 ft² (788.41m²)
	PROPOSED BLDG. B (38)	=	8,486.33 ft² (788.41m²)
	TOTAL (76)	=	16,972.66 ft² (1,576.81m²)

DEVELOPMENT AREAS			
DESCRIPTION	AREA (SF)	AREA (m²)	%
BLDG. A	8,486	788	15.4%
BLDG. B	8,486	788	15.4%
ASPHALT	25,025	2,325	45.3%
CONCRETE	4,780	444	8.7%
LANDSCAPING GRASS	8,455	785	15.3%
TOTAL AREA:	55,232	5,131	100.0%

EXTERIOR DOOR SCHEDULE (ACCESS & EGRESS)


MARK	SIZE	TYPE
1	72"x84"	FULL-LITE ENTRY DOUBLE DOOR
2	34"x84"	FULL-LITE EXIT DOOR
3	36"x84"	FULL-LITE W/ SIDELIGHT EXIT DOOR
4	32"x84"	FULL-LITE GRILLES OFFICE ENTRY DOOR
5	32"x84"	FULL-LITE GRILLES PATIO DOOR

SITE LEGENDS:


SYMBOLS	DEFINITIONS
	PROPERTY LINE
	SETBACK
	UROW LINE AND REGION
	BOLLARD
	TRANSFORMER PAD
	PATHWAY DIRECTION
	BUILDING ENTRY
	BUILDING EXIT
	PROPOSED GARBAGE RECEPTACLE



① PHASING & VICINITY PLAN
N.T.S.

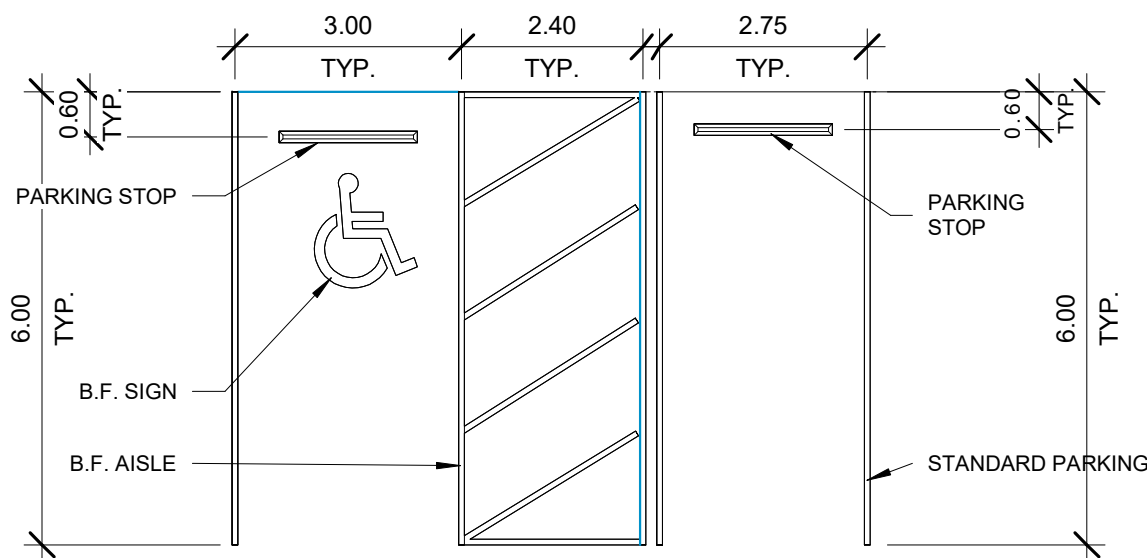


② TYP. PARKING DIMENSION DETAILS
1 : 100

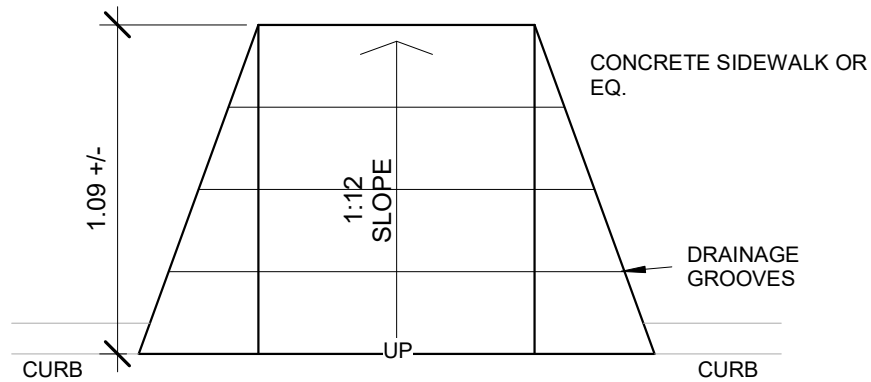

③ BF RAMP DETAIL
1 : 25

2 ST. S.E.

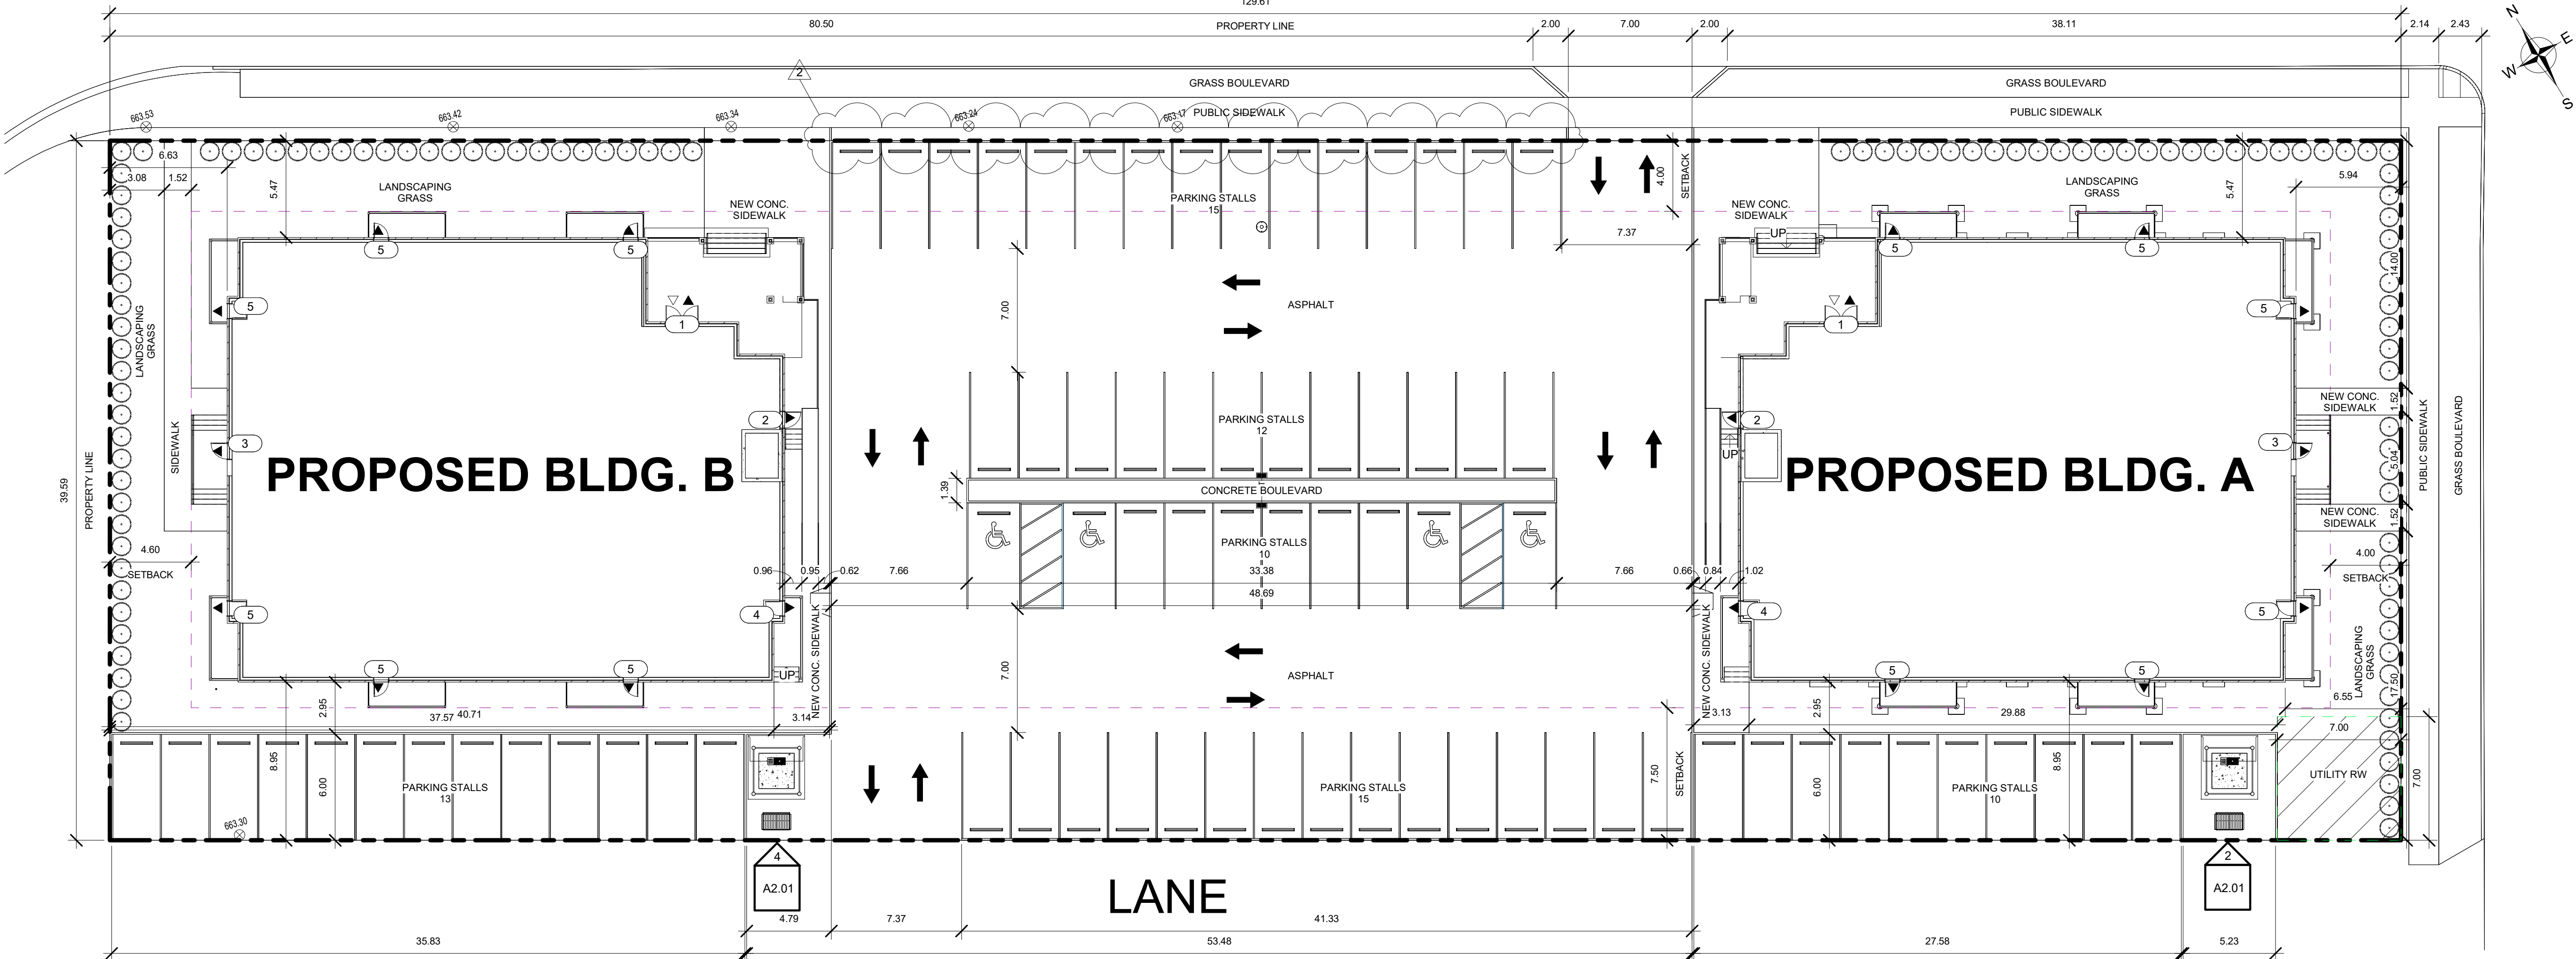

④ SITE
1 : 200

All drawings, design and related documents are the property of: P.H. McNally Associates Ltd., are protected by copyright, and must be returned on request. Reproduction of drawings and documents in part or in whole is forbidden without the Engineer's permission. Drawings and documents are to be used only for the purpose for which they are issued and are not to be used for construction unless signed by the Engineer.

Drawings are not to be used for construction until reviewed and approved by the Authority Having Jurisdiction. This Authority, based on applicable codes, may require revisions and/or additions and this may result in extra costs. These costs are unforeseen and therefore are the responsibility of the Owner and/or Contractor.



Drawings must not be scaled. The Contractor must cross-reference all architectural, structural, foundation, electrical and mechanical drawings and verify all dimensions, drawings and specifications and locations of existing services. Any discrepancies must be reported to the Engineer prior to proceeding with any part of the work. Changes may require revisions and/or additions and this may result in extra costs. These costs are unforeseen and therefore are the responsibility of the Owner and/or Contractor.

The Engineer assumes no responsibility for on-site worker safety for other than their own employees. The owner and/or contractor shall bear responsibility for site safety as per the Occupation Health and Safety Act.

In the event of omissions in the provided service, P.H. McNally Associates limits its liability to the lower of the cost of remediation or payment for the received service.

All physical documents issued are property of the Owner. All intellectual property represented by these documents, as well as material documents, design documents, and digital models remain the property of the Engineer and are used with the Engineer's permission only.

2	DP SUB#2: UTILITY SIZES & CURB	2025-02-19	IAE
BOUNDARIES			
1	DEVELOPMENT PERMIT	2025-01-22	IAE
PRELIMINARY PRESENTATION			
Rev	Description	Date	by

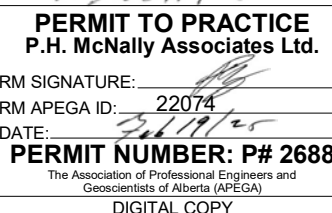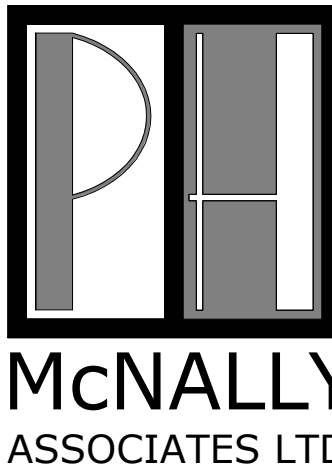

FOR

PROJECT
2 - 38 SUITERS 5 STOREY
APARTMENT

849 - 2 Street SE Medicine Hat, AB

DRAWING TITLE
SITE PLAN - NEW

BY: IAE CHECKED: PHM

SCALE: AS SHOWN PAGE SIZE: 36" x 24"

JOB NO: 24107-01 REV DATE: 2025-02-19

REV. 2 3 14

FOR DEVELOPMENT PERMIT

ASH AVE. S.E.

Pre-Development			
Catchment Zone	Area (ha)	Runoff Coefficient	Modified Coefficient
Impermeable	0.22	0.90	1.00
Compacted Gravel / Soil	0.29	0.6	0.75
Sub-Total	0.51	0.73	0.78

Pre-Development 1 in 5 Year Storm Event					
Area (ha)	Runoff Coefficient	Time of Concentration (min)	Intensity (mm/h)	Q=2.78CA (L/s)	Q=2.78CA (L/s)
A1	0.51	0.73	10	67	69
Total	0.51				

Pre-Development 1 in 100 Year Storm Event						
	Area (ha)	Runoff Coefficient	Time of Concentration (minutes)	QPRECIPITATION (L/s)	QRELEASE (L/s)	Storage (cubic metre/s) Provided
A1	0.51	0.78	10	136	136	0
Total	0.51					

Post-Development			
Catchment Zone	Area (ha)	Runoff Coefficient	Modified Coefficient
A1			
Asphalt	0.02	0.90	1.00
Concrete	0.04	0.90	1.00
Lawn (slope <7%)	0.02	0.10	0.13
Sub-Total	0.08	0.70	0.78
A2			
Impermeable	0.36	0.90	1.00
Sub-Total	0.36	0.90	1.00
A3			
Asphalt	0.02	0.90	1.00
Concrete	0.01	0.90	1.00
Lawn (slope <7%)	0.04	0.10	0.13
Sub-Total	0.07	0.44	0.50

Post-Development 1 in 5 Year Storm Event					
Area (ha)	Runoff Coefficient	Time of Concentration (min)	Intensity (mm/h)	Q=2.78CA (L/s)	Restricted Flow (L/s)
A1	0.08	0.70	10	67	10
A2	0.36	0.90	10	67	60
A3	0.07	0.44	10	67	6
Total	0.51				

Post-Development 1 in 100 Year Storm Event									
Area (ha)	Runoff Coefficient	Time of Concentration (minutes)	Q=2.78CA (L/s)	Q=2.78CA (L/s)	Q=2.78CA (L/s)	Q=2.78CA (L/s)	Q=2.78CA (L/s)	Q=2.78CA (L/s)	Q=2.78CA (L/s)
A1	0.08	0.78	10	19	N/A	19	0	0	0
A2	0.36	1.00	10	123	ICD	103	62	76	0
A3	0.07	0.50	10	12	N/A	12	0	0	0
Total	0.51								

STORM MANHOLE & CATCHBASIN INVERT ELEVATION LEGEND:


MARK	LOCATION	RIM ELEV. (m)	INVERT/S ELEV. (m)	DIA. Ø (mm)	LENGTH (m)	PIPE MATERIAL
EX-ST-MH1	INTERSECTION BETWEEN 2ND ST. SE. & ASH AVE. SE.	662.75	S: 660.12	300	EXISTING	PVC
ST-MH1	ON THE SITE OF NEW PARKING LOT	662.97	SW: 660.96 S: 660.96 SE: 660.96 W: 660.91	150 150 150 200	35.45 +/- 15.46 +/- 35.45 +/- 76.94 +/-	PVC SDR-35
EX-ST-CB1	2ND ST. SE. SITE UPPER RIGHT CORNER	662.46	E: 661.78	250	EXISTING	STEEL
ST-CB1	ON THE SITE OF NEW ISLAND OF PARKING LOT (NORTH SIDE)	662.68	N: 661.14 S: 661.17	150	15.46 +/-	PVC SDR-35
ST-CB2	ON THE SITE OF NEW ISLAND OF PARKING LOT (SOUTH SIDE)	662.68	N: 661.19	150	15.46 +/-	PVC SDR-35
ST-LINE INTO BLDG. A	SE OF ST-MH1 TIES TO BLDG. A ROOF DRAIN	-	N: 661.25	150	35.45 +/-	PVC SDR-35
ST-LINE INTO BLDG. B	SW OF ST-MH1 TIES TO BLDG. B ROOF DRAIN	-	N: 661.25	150	35.45 +/-	PVC SDR-35

SITE STORMWATER & GRADING LEGENDS:

SYMBOLS	DEFINITIONS
EX-ST—EX-ST—EX-ST	BURIED EXISTING STORMWATER LINE
ST—ST—ST	BURIED STORMWATER LINE
---	PROPERTY LINE
---	EXISTING CONTOUR LINE
---	PROPOSE CONTOUR LINE
⊗	EXISTING GRADING SYMBOL
⊗	PROPOSE GRADING SYMBOL
---	AREA DRAINAGE BOUNDARY LINE
---	A1 (TO GROUNDWATER OR STREET)
---	A2 (TO NEW STORM MANHOLE)
---	A3 (TO GROUNDWATER OR STREET)
⊗	MANHOLE
⊗	CATCHBASIN

NOTES:

- NEW CB1 AND CB2 ARE TIE TO EACH OTHER.
- GRADE LEVEL SLOPE 2% AWAY FROM THE BUILDING

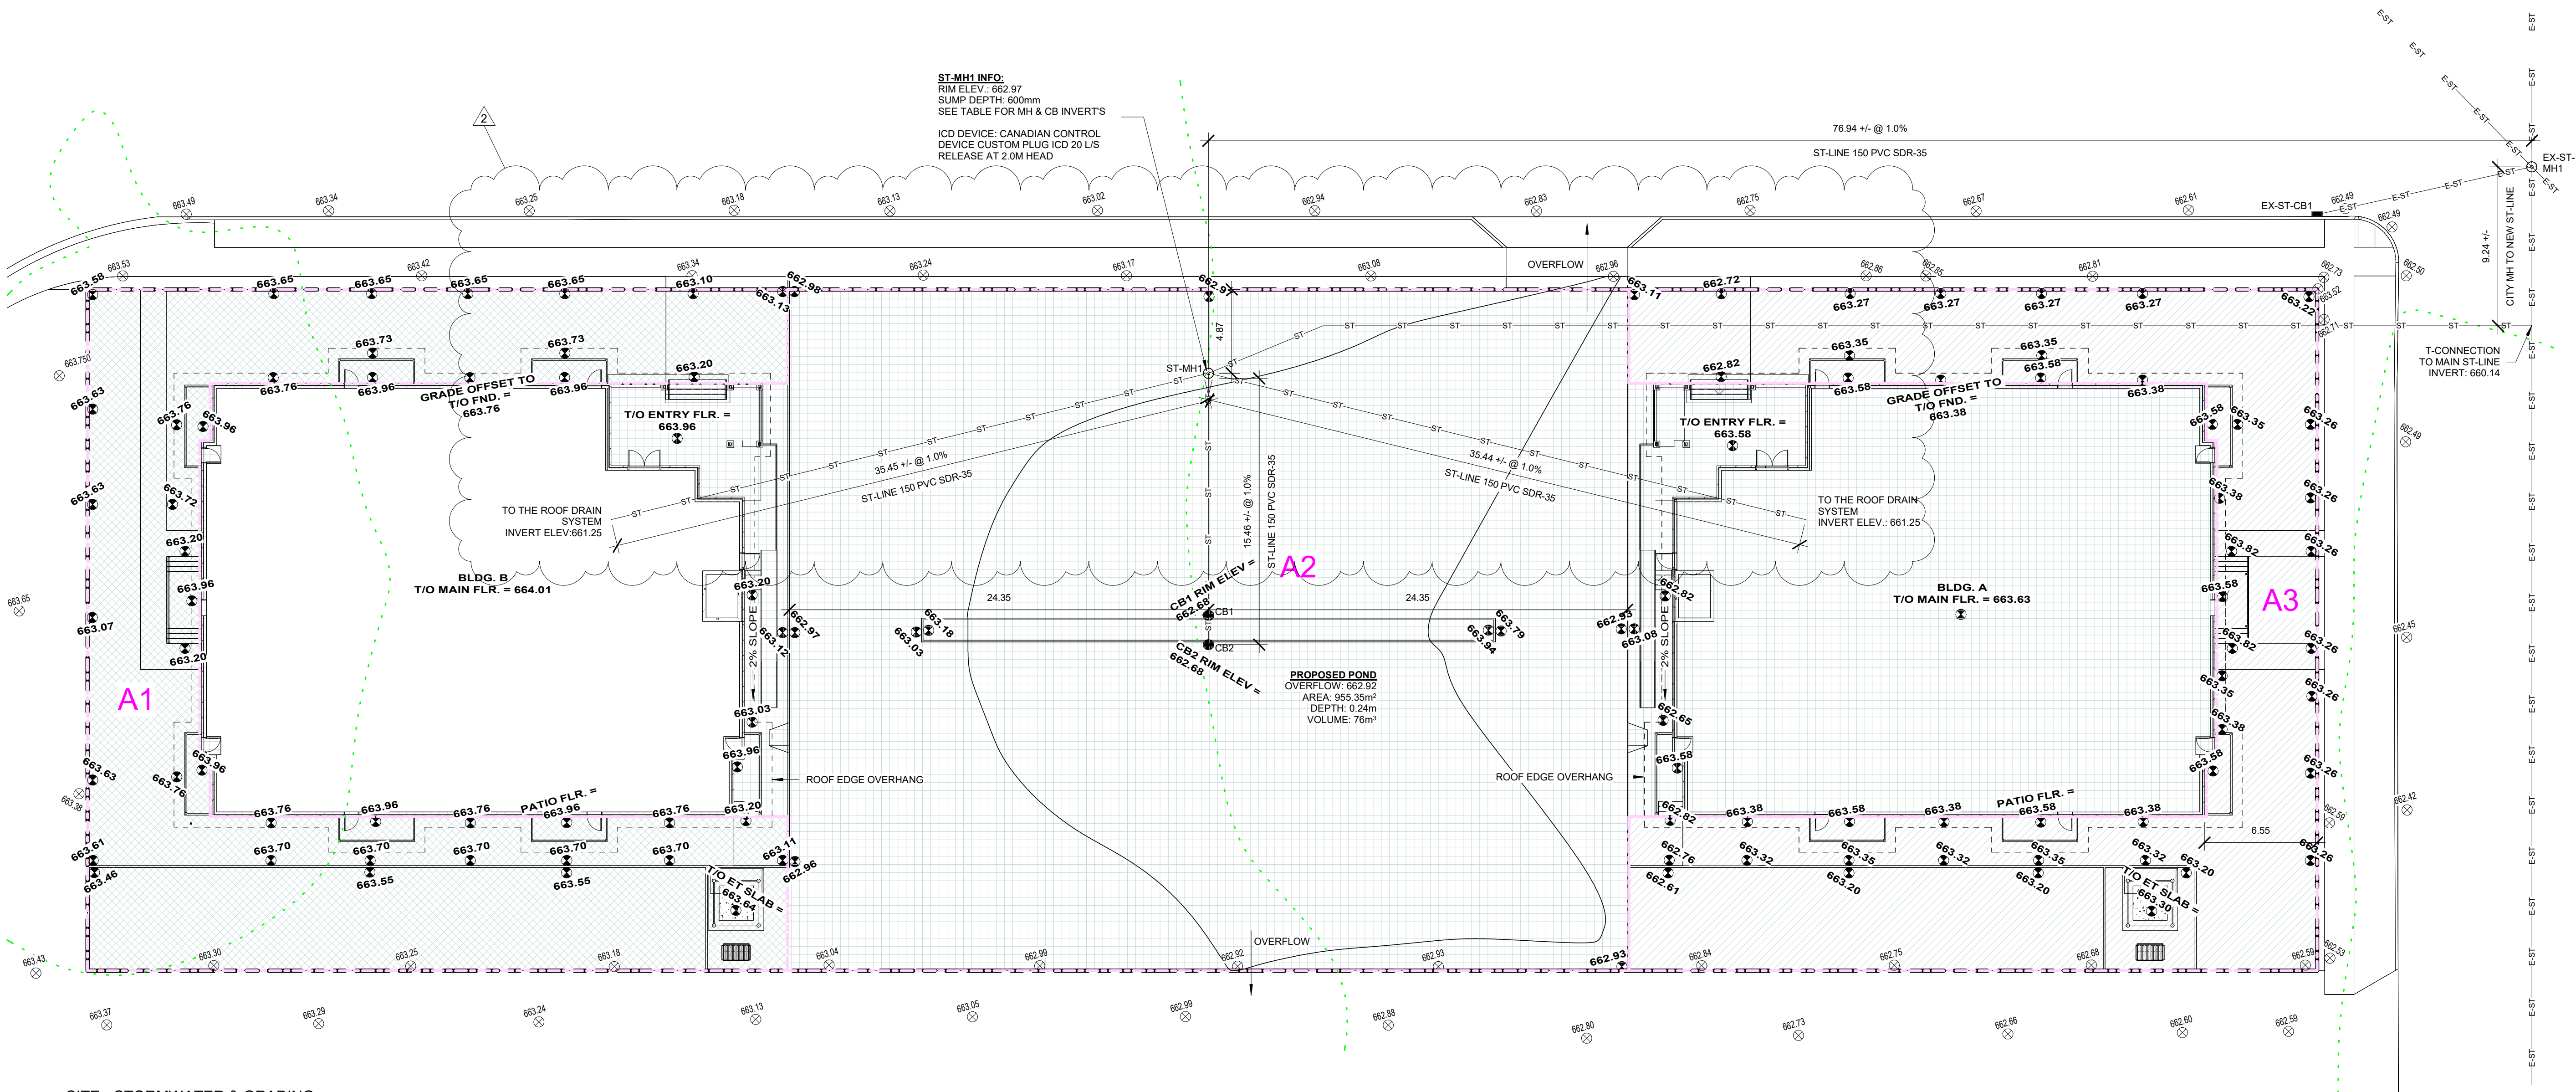

All drawings, design and related documents are the property of: P.H. McNally Associates Ltd., are protected by copyright, and must be returned on request. Reproduction of drawings and documents in part or in whole is forbidden without the Engineer's permission. Drawings and documents are to be used only for the purpose for which they are issued and are not to be used for construction unless signed by the Engineer.

Drawings are not to be used for construction until reviewed and approved by the Authority Having Jurisdiction. This Authority, based on applicable codes, may require revisions and/or additions and this may result in extra costs. These costs are unforeseen and therefore are the responsibility of the Owner and/or Contractor.

Drawings must not be scaled. The Contractor must cross-reference all architectural, structural, foundation, electrical and mechanical drawings and verify all dimensions, drawings and specifications and locations of existing services. Any discrepancies must be reported to the Engineer prior to proceeding with any part of the work. Changes may require revisions and/or additions and this may result in extra costs. These costs are unforeseen and therefore are the responsibility of the Owner and/or Contractor.


The Engineer assumes no responsibility for on-site worker safety for other than their own employees. The owner and/or contractor shall bear responsibility for site safety as per the Occupational Health and Safety Act.

In the event of omissions in the provided service, P.H. McNally Associates limits its liability to the lower of the cost of remediation or payment for the received service.

All physical documents issued are property of the Owner. All intellectual property represented by these documents, as well as material documents, design documents, and digital models remain the property of the Engineer and are used with the Engineer's permission only.

2	DP SUB#2: UTILITY SIZES & CURB	2025-02-19	IAE
1	DEVELOPMENT PERMIT	2025-01-22	IAE
	PRELIMINARY PRESENTATION	2024-11-06	IAE

Rev	Description	Date	by
-----	-------------	------	----

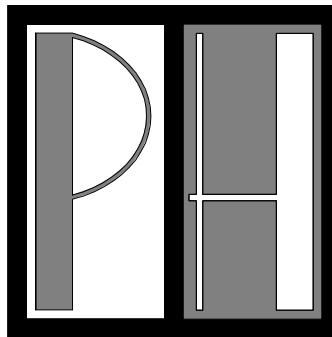

McNALLY
ASSOCIATES LTD.



PERMIT TO PRACTICE
P.H. McNally Associates Ltd.
RM SIGNATURE: _____
RM APEGA ID: 22074
DATE: 2024-11-06
PERMIT NUMBER: P# 2688
DIGITAL COPY

FOR

PROJECT
2 - 38 SUITERS 5 STOREY
APARTMENT

849 - 2 Street SE Medicine Hat, AB

DRAWING TITLE
SITE PLAN - STORMWATER &
GRADING

BY: IAE CHECKED: PHM

SCALE: AS SHOWN PAGE SIZE: 36" x 24"

JOB NO: 24107-01 REV DATE: 2025-02-19



REV.
2 5
14

FOR DEVELOPMENT PERMIT

1 SITE - STORMWATER & GRADING
1 : 200


NOTES:

- BUILDING A & B ARE MIRROR LAYOUTS.
- BUILDING A & B GRADE LEVEL ARE DIFFERENT. SEE SITE GRADING PLAN.
- GRADE LEVEL SLOPE 2% AWAY FROM THE BUILDING

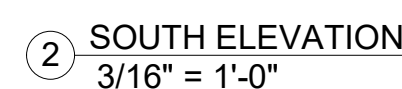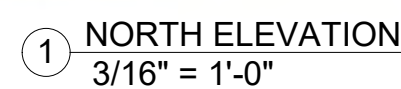

All physical documents issued are property of the Owner. All intellectual property represented by these documents, as well as material documents, design documents, and digital models remain the property of the Engineer and are used with the Engineer's permission only.

McNALLY
ASSOCIATES LTD

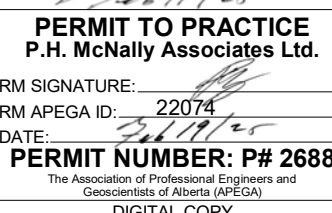

EQF

PROJECT
2 - 38 SUITERS 5 STOREY
APARTMENT

849 - 2 Street SE Medicine Hat, AB

DRAWING TITLE
ELEVATION VIEW - BLDG. A

BY: IAE CHECKED: PHM

SCALE: AS SHOWN PAGE SIZE: 36" x 24"

JOB NO. 24107-01 REV DATE: 2025-02-15

REV. 12

A2.00


FOR DEVELOPMENT PERMIT




① EAST ELEVATION
3/16" = 1'-0"



③ WEST ELEVATION
3/16" = 1'-0"

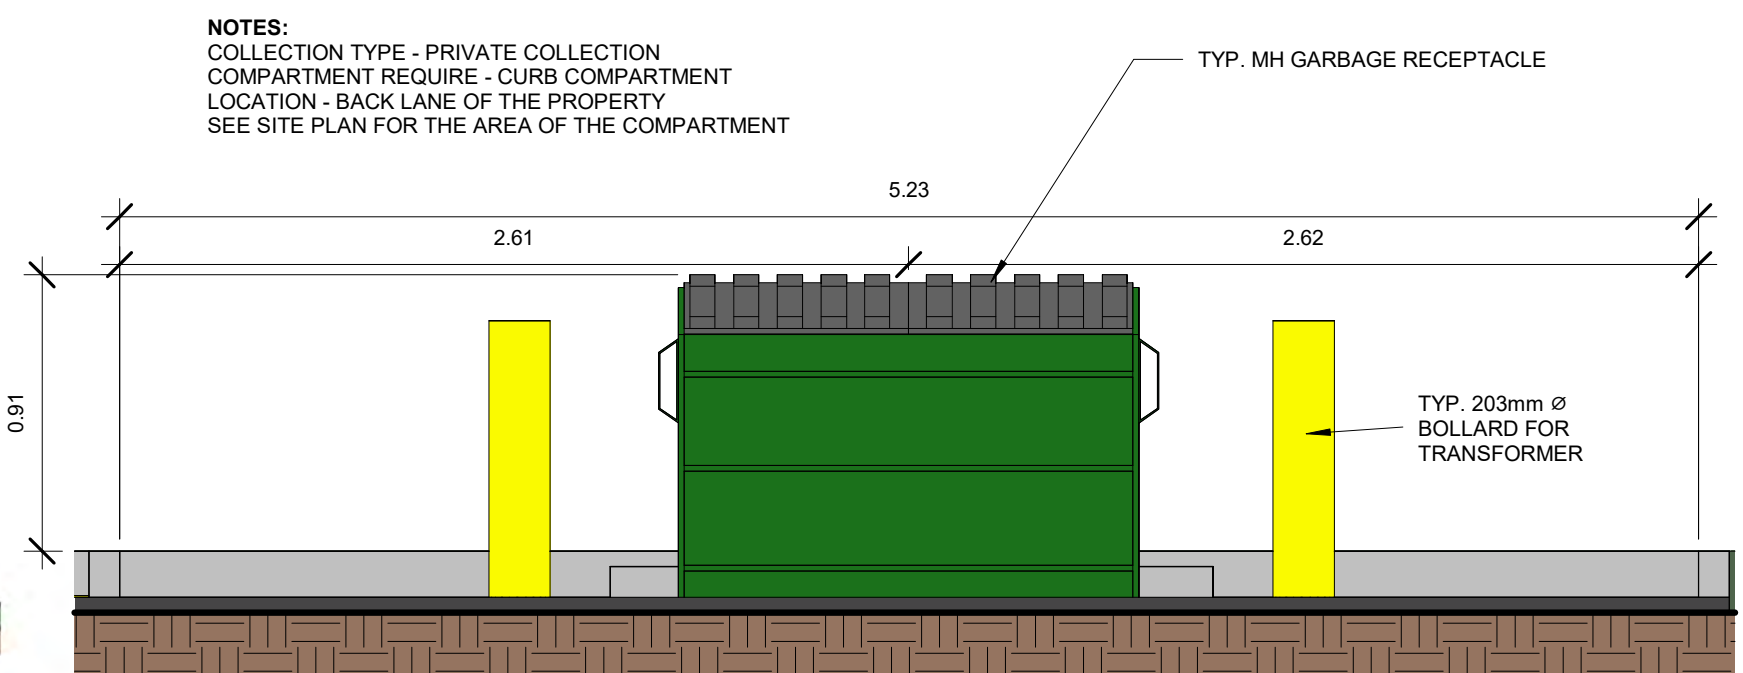

GARBAGE COMPARTMENT ELEVATION -
BUILDING A
② 1 : 25

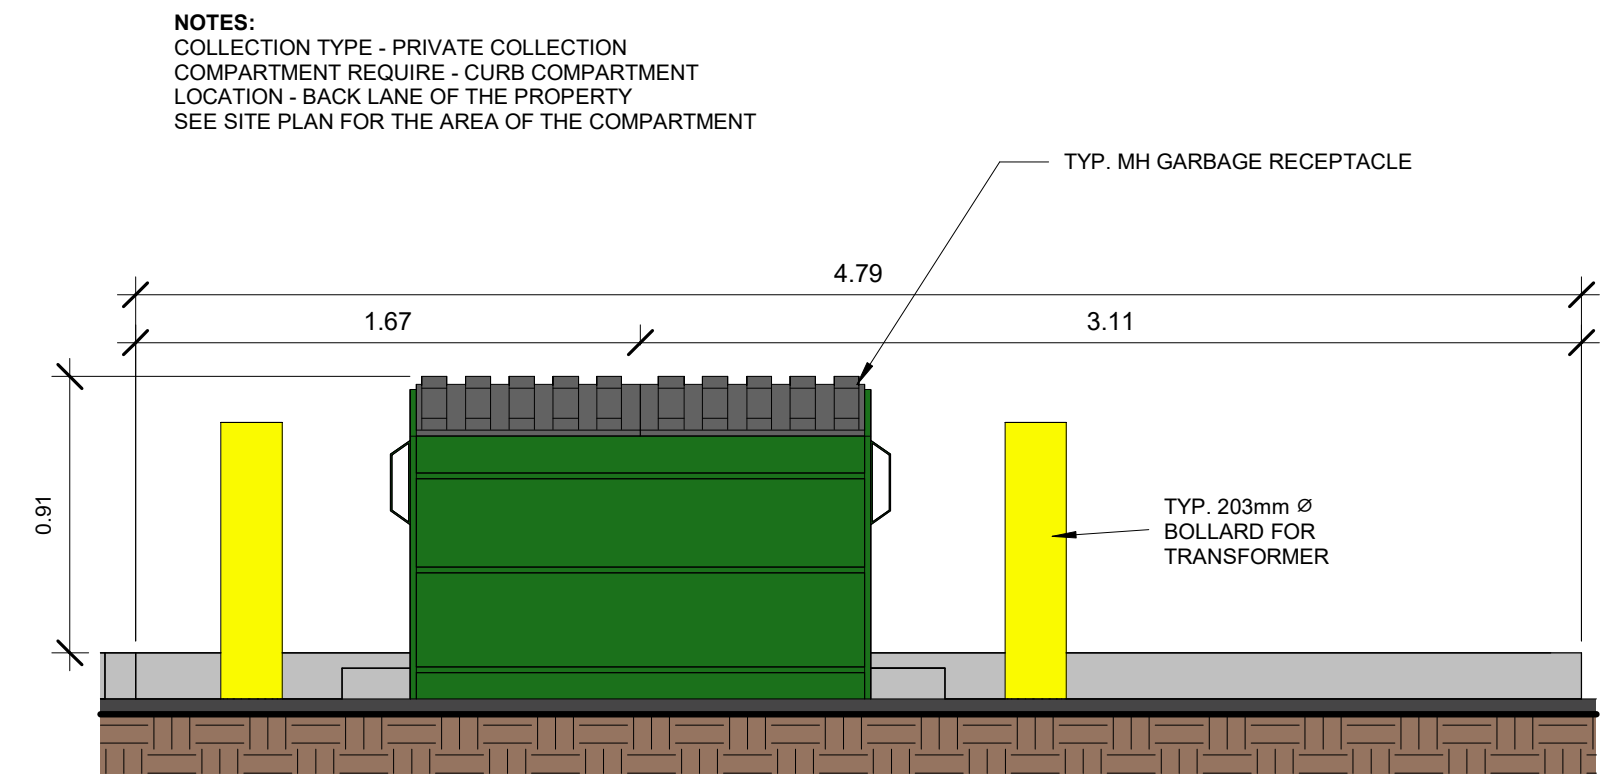

GARBAGE COMPARTMENT ELEVATION -
BUILDING B
④ 1 : 25

All drawings, design and related documents are the property of: P.H. McNally Associates Ltd., are protected by copyright, and must be returned on request. Reproduction of drawings and documents in part or in whole is forbidden without the Engineer's permission. Drawings and documents are to be used only for the purpose for which they are issued and are not to be used for construction unless signed by the Engineer.

Drawings are not to be used for construction until reviewed and approved by the Authority Having Jurisdiction. This Authority, based on applicable codes, may require revisions and/or additions and this may result in extra costs. These costs are unforeseen and therefore are the responsibility of the Owner and/or Contractor.


Drawings must not be scaled. The Contractor must cross-reference all architectural, structural, foundation, electrical and mechanical drawings and verify all dimensions, drawings and specifications and locations of existing services. Any discrepancies must be reported to the Engineer prior to proceeding with any part of the work. Changes may require revisions and/or additions and this may result in extra costs. These costs are unforeseen and therefore are the responsibility of the Owner and/or Contractor.

The Engineer assumes no responsibility for on-site worker safety for other than their own employees. The owner and/or contractor shall bear responsibility for site safety as per the Occupation Health and Safety Act.

In the event of omissions in the provided service, P.H. McNally Associates limits its liability to the lower of the cost of remediation or payment for the received service.

All physical documents issued are property of the Owner. All intellectual property represented by these documents, as well as material documents, design documents, and digital models remain the property of the Engineer and are used with the Engineer's permission only.

2	DP SUB#2: UTILITY SIZES & CURB BOUNDARIES	2025-02-19	IAE
1	DEVELOPMENT PERMIT PRELIMINARY PRESENTATION	2025-01-22	IAE
Rev	Description	Date	by

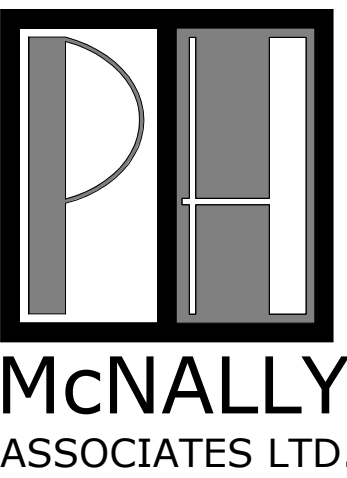

PERMIT TO PRACTICE
P.H. McNally Associates Ltd.
RM SIGNATURE: [Signature]
PERMIT NUMBER: P# 2688
DIGITAL COPY

FOR	PROJECT
	2 - 38 SUITERS 5 STOREY APARTMENT
	849 - 2 Street SE Medicine Hat, AB
	DRAWING TITLE
	ELEVATION VIEW - BLDG. A
BY: IAE	CHECKED: PHM
SCALE: AS SHOWN	PAGE SIZE: 36" x 24"
JOB NO: 24107-01	REV DATE: 2025-02-19
A2.01	REV. 2 13 14



① 3D VIEW 1
N.T.S.



② 3D VIEW 2
N.T.S.

All drawings, design and related documents are the property of: P.H. McNally Associates Ltd., are protected by copyright, and must be returned on request. Reproduction of drawings and documents in part or in whole is forbidden without the Engineer's permission. Drawings and documents are to be used only for the purpose for which they are issued and are not to be used for construction unless signed by the Engineer.

Drawings are not to be used for construction until reviewed and approved by the Authority Having Jurisdiction. This Authority, based on applicable codes, may require revisions and/or additions and this may result in extra costs. These costs are unforeseen and therefore are the responsibility of the Owner and/or Contractor.

Drawings must not be scaled. The Contractor must cross-reference all architectural, structural, foundation, electrical and mechanical drawings and verify all dimensions, drawings and specifications and locations of existing services. Any discrepancies must be reported to the Engineer prior to proceeding with any part of the work. Changes may require revisions and/or additions and this may result in extra costs. These costs are unforeseen and therefore are the responsibility of the Owner and/or Contractor.


The Engineer assumes no responsibility for on-site worker safety for other than their own employees. The owner and/or contractor shall bear responsibility for site safety as per the Occupation Health and Safety Act.

In the event of omissions in the provided service, P.H. McNally Associates limits its liability to the lower of the cost of remediation or payment for the received service.

All physical documents issued are property of the Owner. All intellectual property represented by these documents, as well as material documents, design documents, and digital models remain the property of the Engineer and are used with the Engineer's permission only.

2	DP SUB#2: UTILITY SIZES & CURB BOUNDARIES	2025-02-19	IAE
1	DEVELOPMENT PERMIT PRELIMINARY PRESENTATION	2025-01-22	IAE
1	PRELIMINARY PRESENTATION	2024-11-06	IAE

Rev	Description	Date	by
-----	-------------	------	----

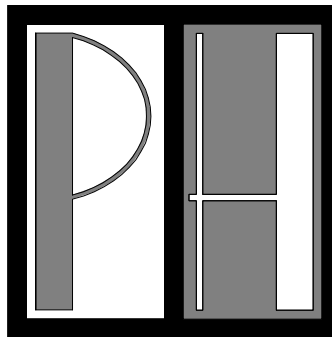

McNALLY
ASSOCIATES LTD.



PERMIT TO PRACTICE
P.H. McNally Associates Ltd.
RM SIGNATURE: [Signature]
RM APEGA ID: 22074
DATE: [Date]
PERMIT NUMBER: P# 2688
DIGITAL COPY

FOR

PROJECT
2 - 38 SUITERS 5 STOREY
APARTMENT

849 - 2 Street SE Medicine Hat, AB

DRAWING TITLE
3D VIEW

BY: IAE CHECKED: PHM

SCALE: AS SHOWN PAGE SIZE: 36" x 24"

JOB NO: 24107-01 REV DATE: 2025-02-19

A9.00 2 14 14

FOR DEVELOPMENT PERMIT